

ANNOTATED MARKED-UP  
DRAWINGS



100

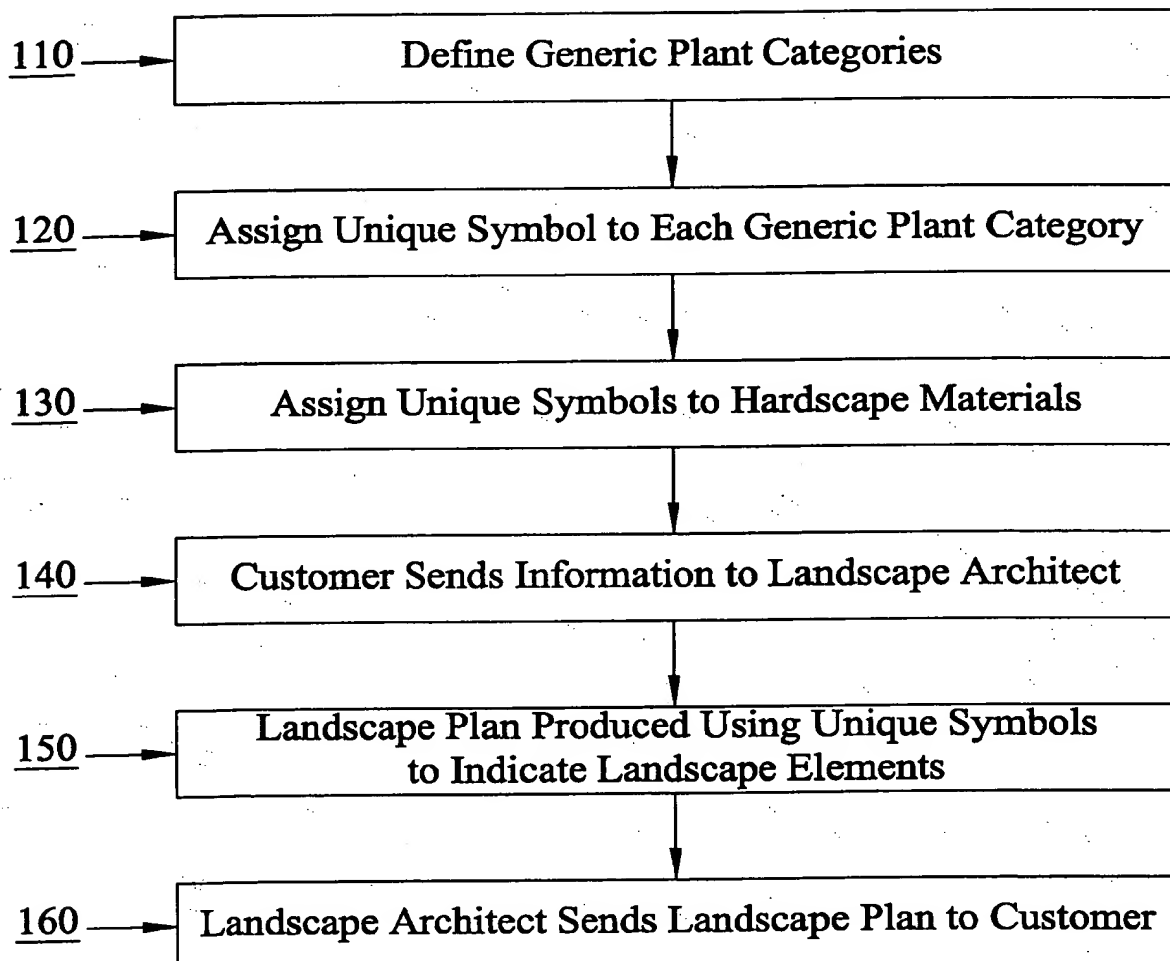



FIGURE 1

# ANNOTATED MARKED-UP DRAWINGS



FIGURE 2

*deleted line*

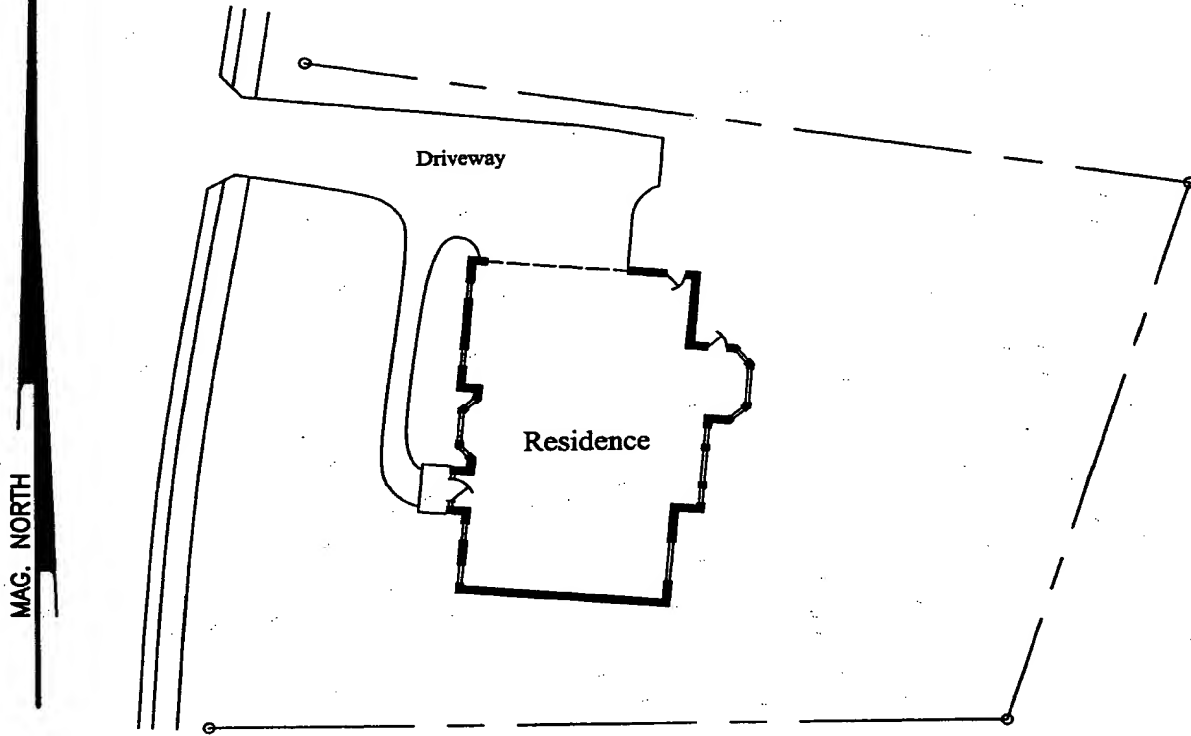

## LEGEND


WM - WATER METER  
WV - WATER VALVE  
PK - PK NAIL PLACED  
GM - GAS METER  
LP - LIGHT POLE

R/W - RIGHT OF WAY  
IPP - IRON PIN PLACED  
IPF - IRON PIN FOUND  
CM - CONCRETE MARKER  
CH. - CHORD  
L OR A - LENGTH OF CURVE

R - RADIUS PP - POWER POLE  
- X - X - FENCE  
- - - LAND LOT LINE  
C - CENTER LINE  
- w - POWER LINE  
B/L - BUILDING SETBACK LINE

*fixed margin*

○ fixed margins

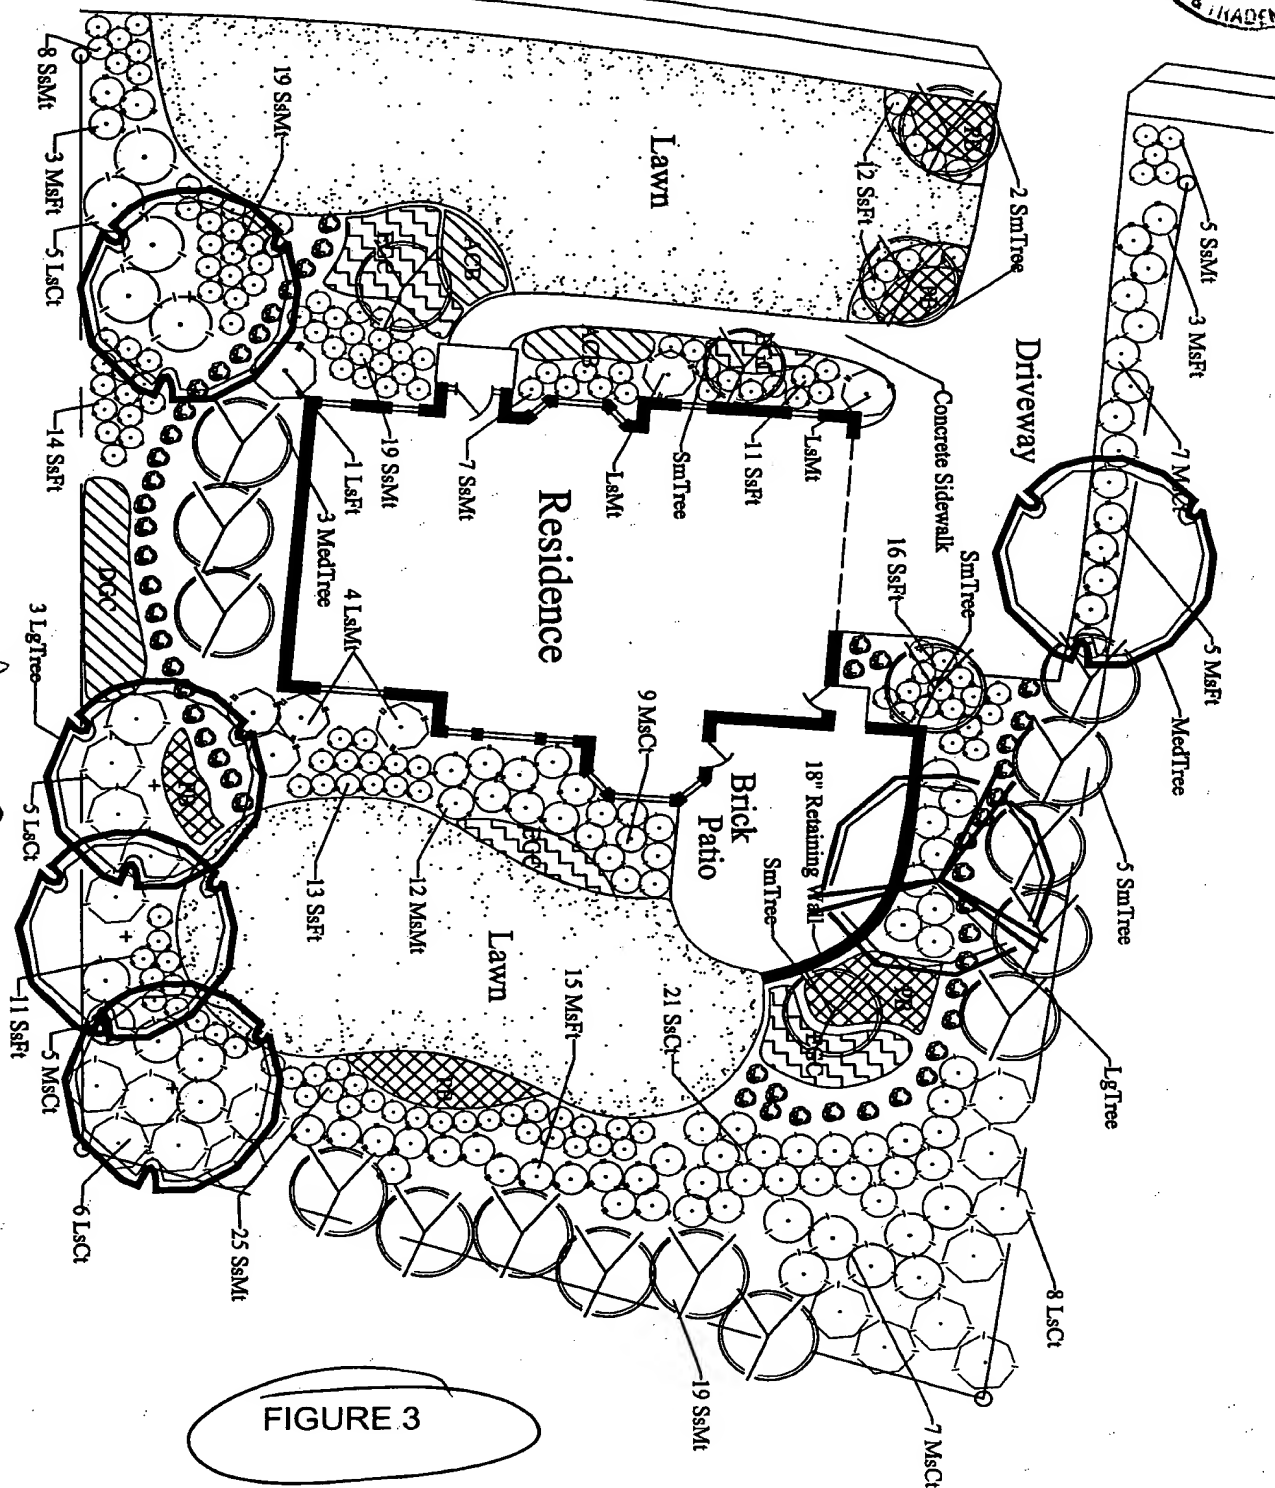

**FIGURE 3**

**BEST AVAILABLE COPY**

# ANNOTATED MARKED-UP DRAWINGS



FIGURE 4

Symbol	Key	Quantity	Plant Type	Characteristics
	ACB	85	Annual Color Bed	Annual Flowers measured in square feet.
	EGC	250	Evergreen Groundcover	Spreading evergreen plant material up to 18" in height measured in square feet.
	DGC	100	Deciduous Groundcover	Spreading deciduous plant material up to 18" in height measured in square feet.
	PB	200	Perennial Bed	Perennial Flowering Plants measured in square feet.
	SsFt	77	Small Shrub Fine Texture	Shrub up to 36" in height and width. Leaf size less than 3/4"
	SsMt	76	Small Shrub Medium Texture	Shrub up to 36" in height and width. Leaf size of 3/4" - 2"
	SsCt	21	Small Shrub Coarse Texture	Shrub up to 36" in height and width. Leaf size greater than 2"
	MsFt	26	Medium Shrub Fine Texture	Shrub 36" - 60" in height and width. Leaf size less than 3/4"
	MsMt	12	Medium Shrub Medium Texture	Shrub 36" - 60" in height and width. Leaf size of 3/4" - 2"
	MsCt	7	Medium Shrub Coarse Texture	Shrub 36" - 60" in height and width. Leaf size greater than 2"
	LsFt	1	Large Shrub Fine Texture	Shrub greater than 60" in height and width. Leaf size less than 3/4"
	LsMt	6	Large Shrub Medium Texture	Shrub greater than 60" in height and width. Leaf size of 3/4" - 2"
	LsCt	24	Large Shrub Coarse Texture	Shrub greater than 60" in height and width Leaf size greater than 2"
	Small Tree	13	Small Tree	Tree less than 25' tall
	Med. Tree	4	Medium Tree	Tree 25' - 40' tall
	Large Tree	4	Large Tree	Tree greater than 40' tall